


Based on Ordnance Survey mapping with the permission of the Controller of Her Majesty's Stationery Office. Crown copyright. Unauthorised reproduction infringes Crown copyright and may lead to prosecution or civil proceedings.
Lancashire County Council Licence No. LA1000232320

- A** CROSSING ROUTE PROPOSED BY BRITISH HORSE SOCIETY
- B** POSSIBLE WIDENING TO CREATE 2 CROSSING LANES (WOULD REQUIRE A STRIP OF LAND FROM HEALTH CENTRE (SHOWN IN GREEN HATCH))

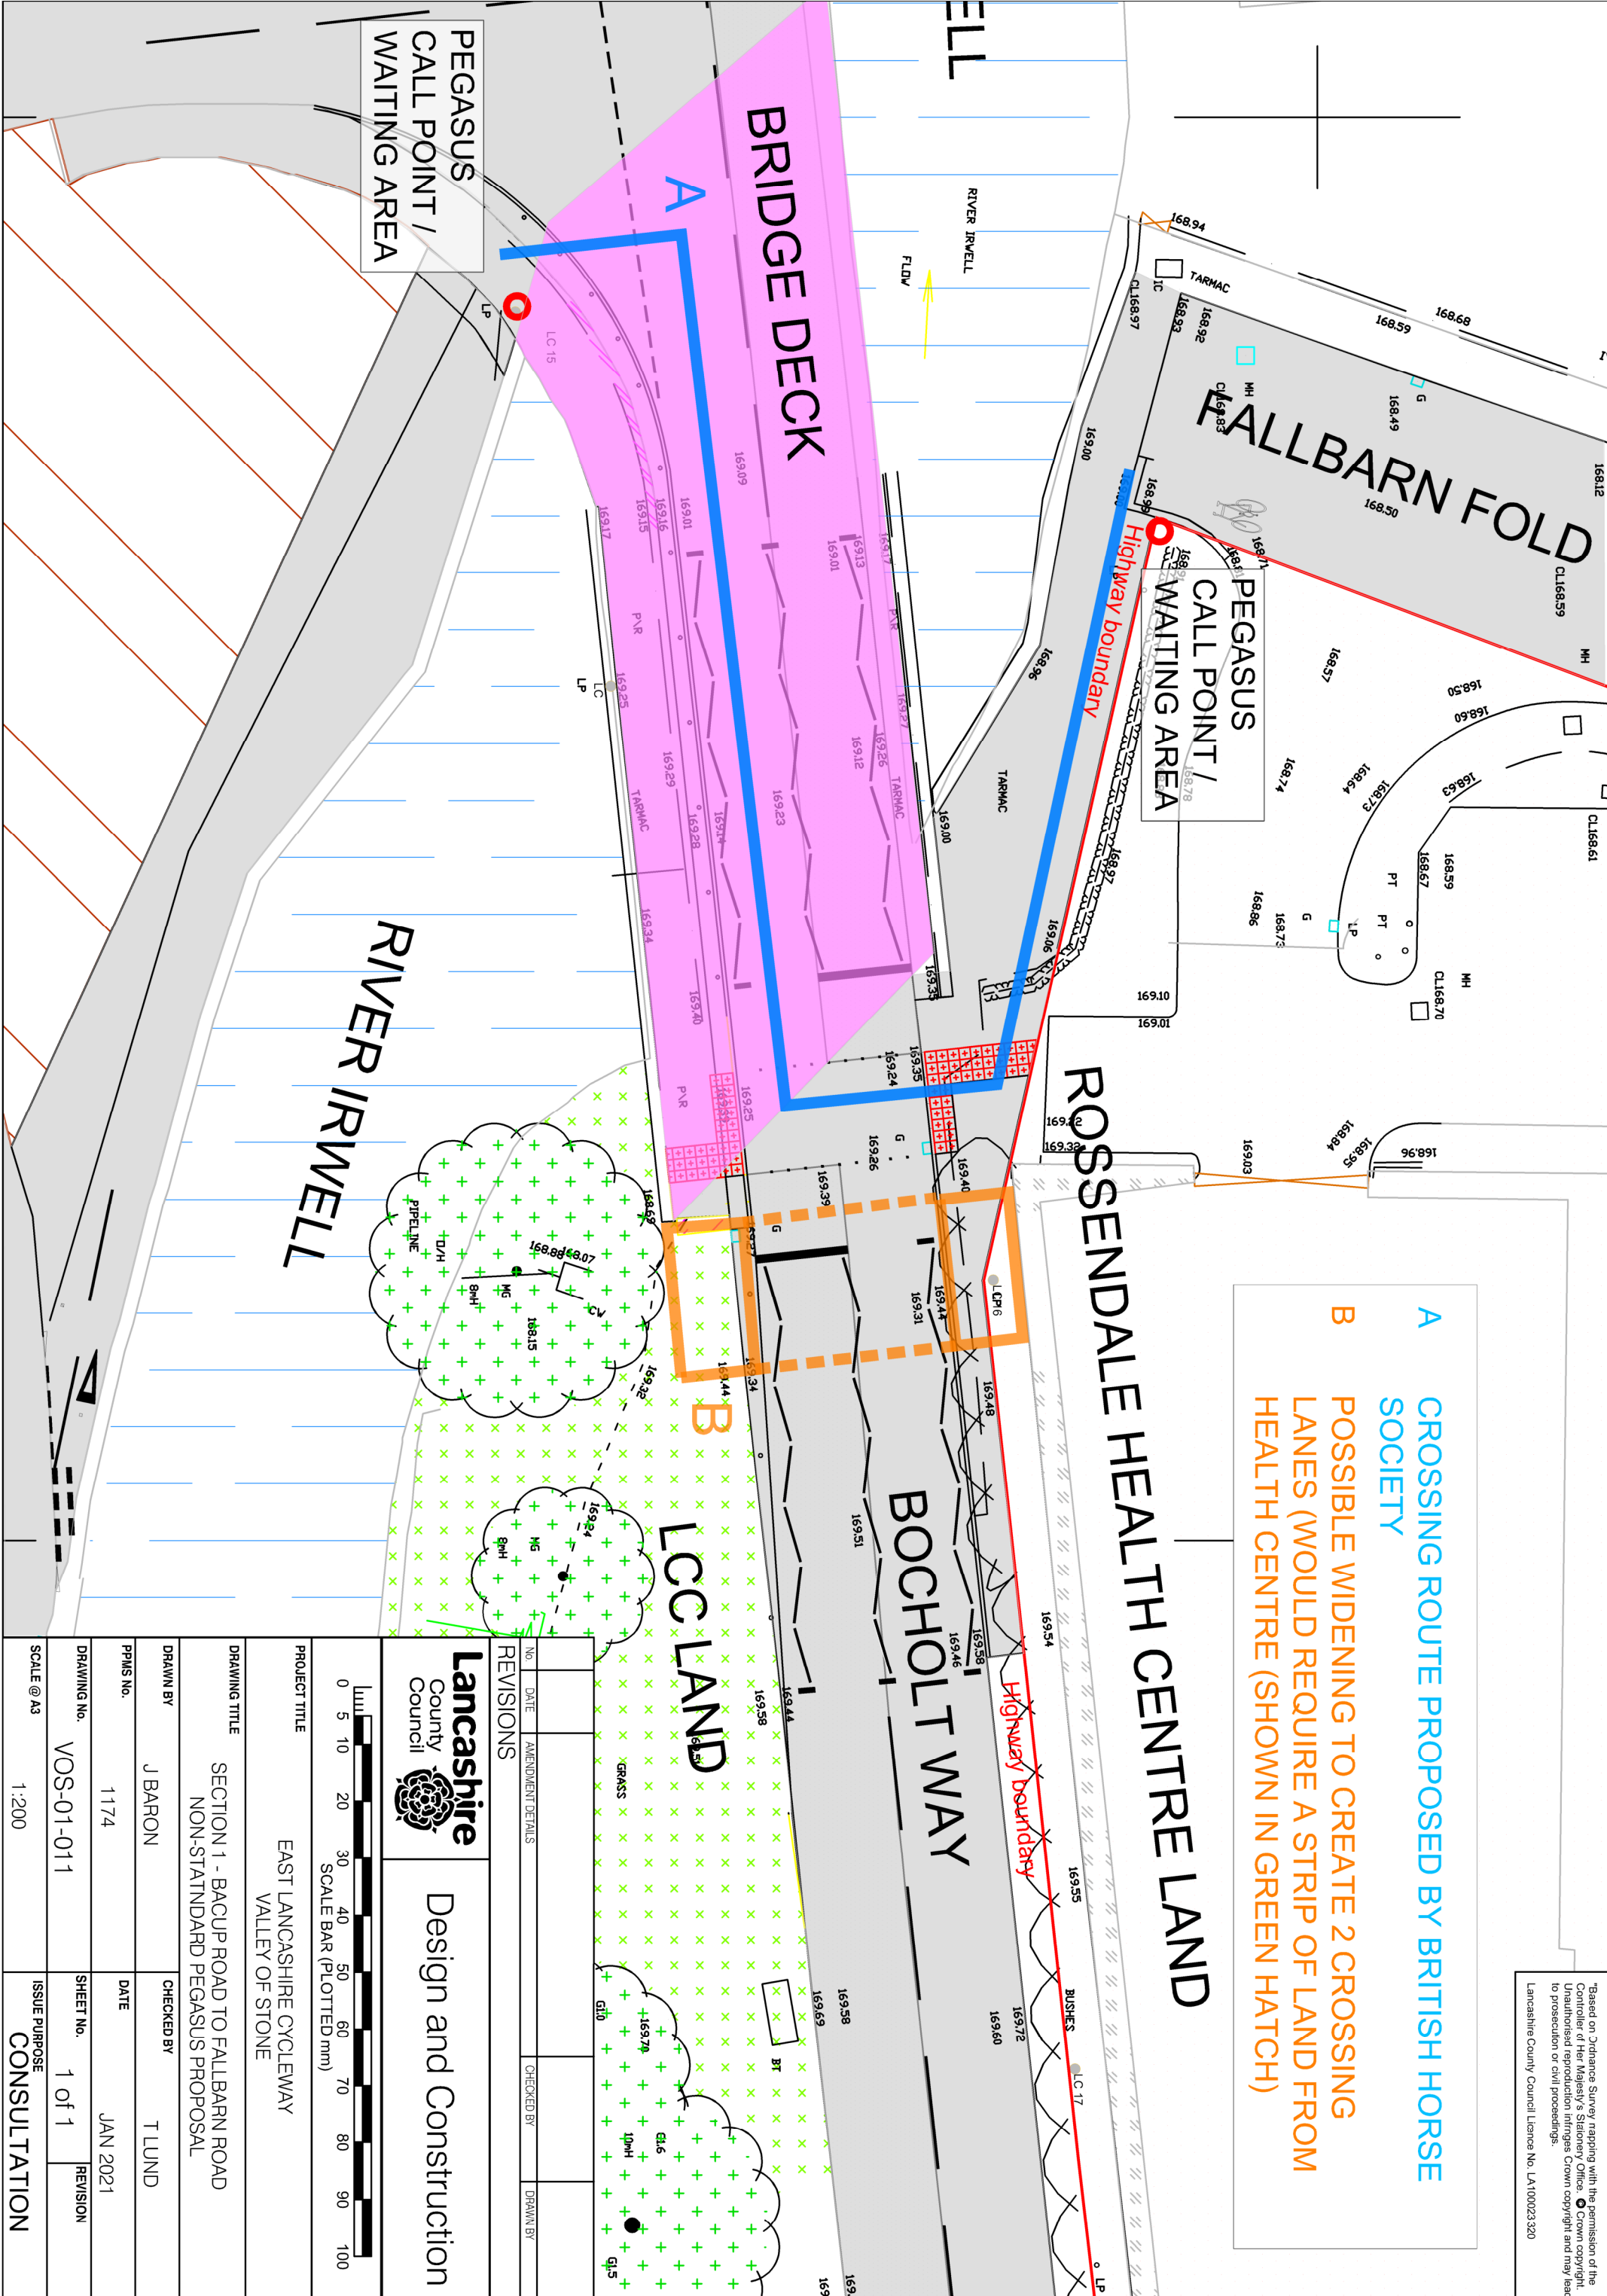

Lancashire County Council Design and Construction

PROJECT TITLE: EAST LANCASHIRE CYCLEWAY VALLEY OF STONE

DRAWING TITLE: SECTION 1 - BACUP ROAD TO FALLBARN ROAD NON-STATANDARD PEGASUS PROPOSAL

DRAWN BY: J BARON
CHECKED BY: T LUND

PPMS No.: 1174
DATE: JAN 2021

DRAWING No.: VOS-01-011
SHEET No.: 1 of 1
REVISION: CONSULTATION

SCALE @ A3: 1:200

ISSUE PURPOSE: CONSULTATION

REVISIONS

No.	DATE	AMENDMENT DETAILS	CHECKED BY	DRAWN BY

